


**CONSTRUCTION NOTES:**

- RR REMOVE AND REUSE EXISTING EQUIPMENT.
- E EXISTING SIGNAGE TO REMAIN.
- 1 PAVEMENT MARKINGS PER CALTRANS STANDARDS. ALL PAVEMENT MARKINGS SHALL BE THERMOPLASTIC.
- 2 INSTALL TRAFFIC SIGN PER CITY OF RIVERSIDE STD. DWG. 666.
- 3 WET SANDBLAST CONFLICTING STRIPING. REMOVE CONFLICTING RAISED PAVEMENT MARKERS.
- 4 INSTALL 12" SOLID WHITE STRIPE, THERMOPLASTIC.
- 5 INSTALL 8" SOLID WHITE CHANNELIZING LINE-DETAIL 38., THERMOPLASTIC.
- 7 PAINT 4" WHITE STRIPE.
- 8 PAINT MEDIAN NOSE CURBING REFLECTIVE YELLOW.
- 9 PAINT 4" WHITE STRIPE, DETAIL 12.
- 12 PAINT 6" WHITE BIKE LANE INTERSECTION LINE, DETAIL 39A.
- 13 PAINT 6" SOLID WHITE BIKE LANE LINE, DETAIL 39.
- 14 PAINT DOUBLE YELLOW STRIPE, DETAIL 21.
- 15 CONSTRUCT SIGN PER PLAN

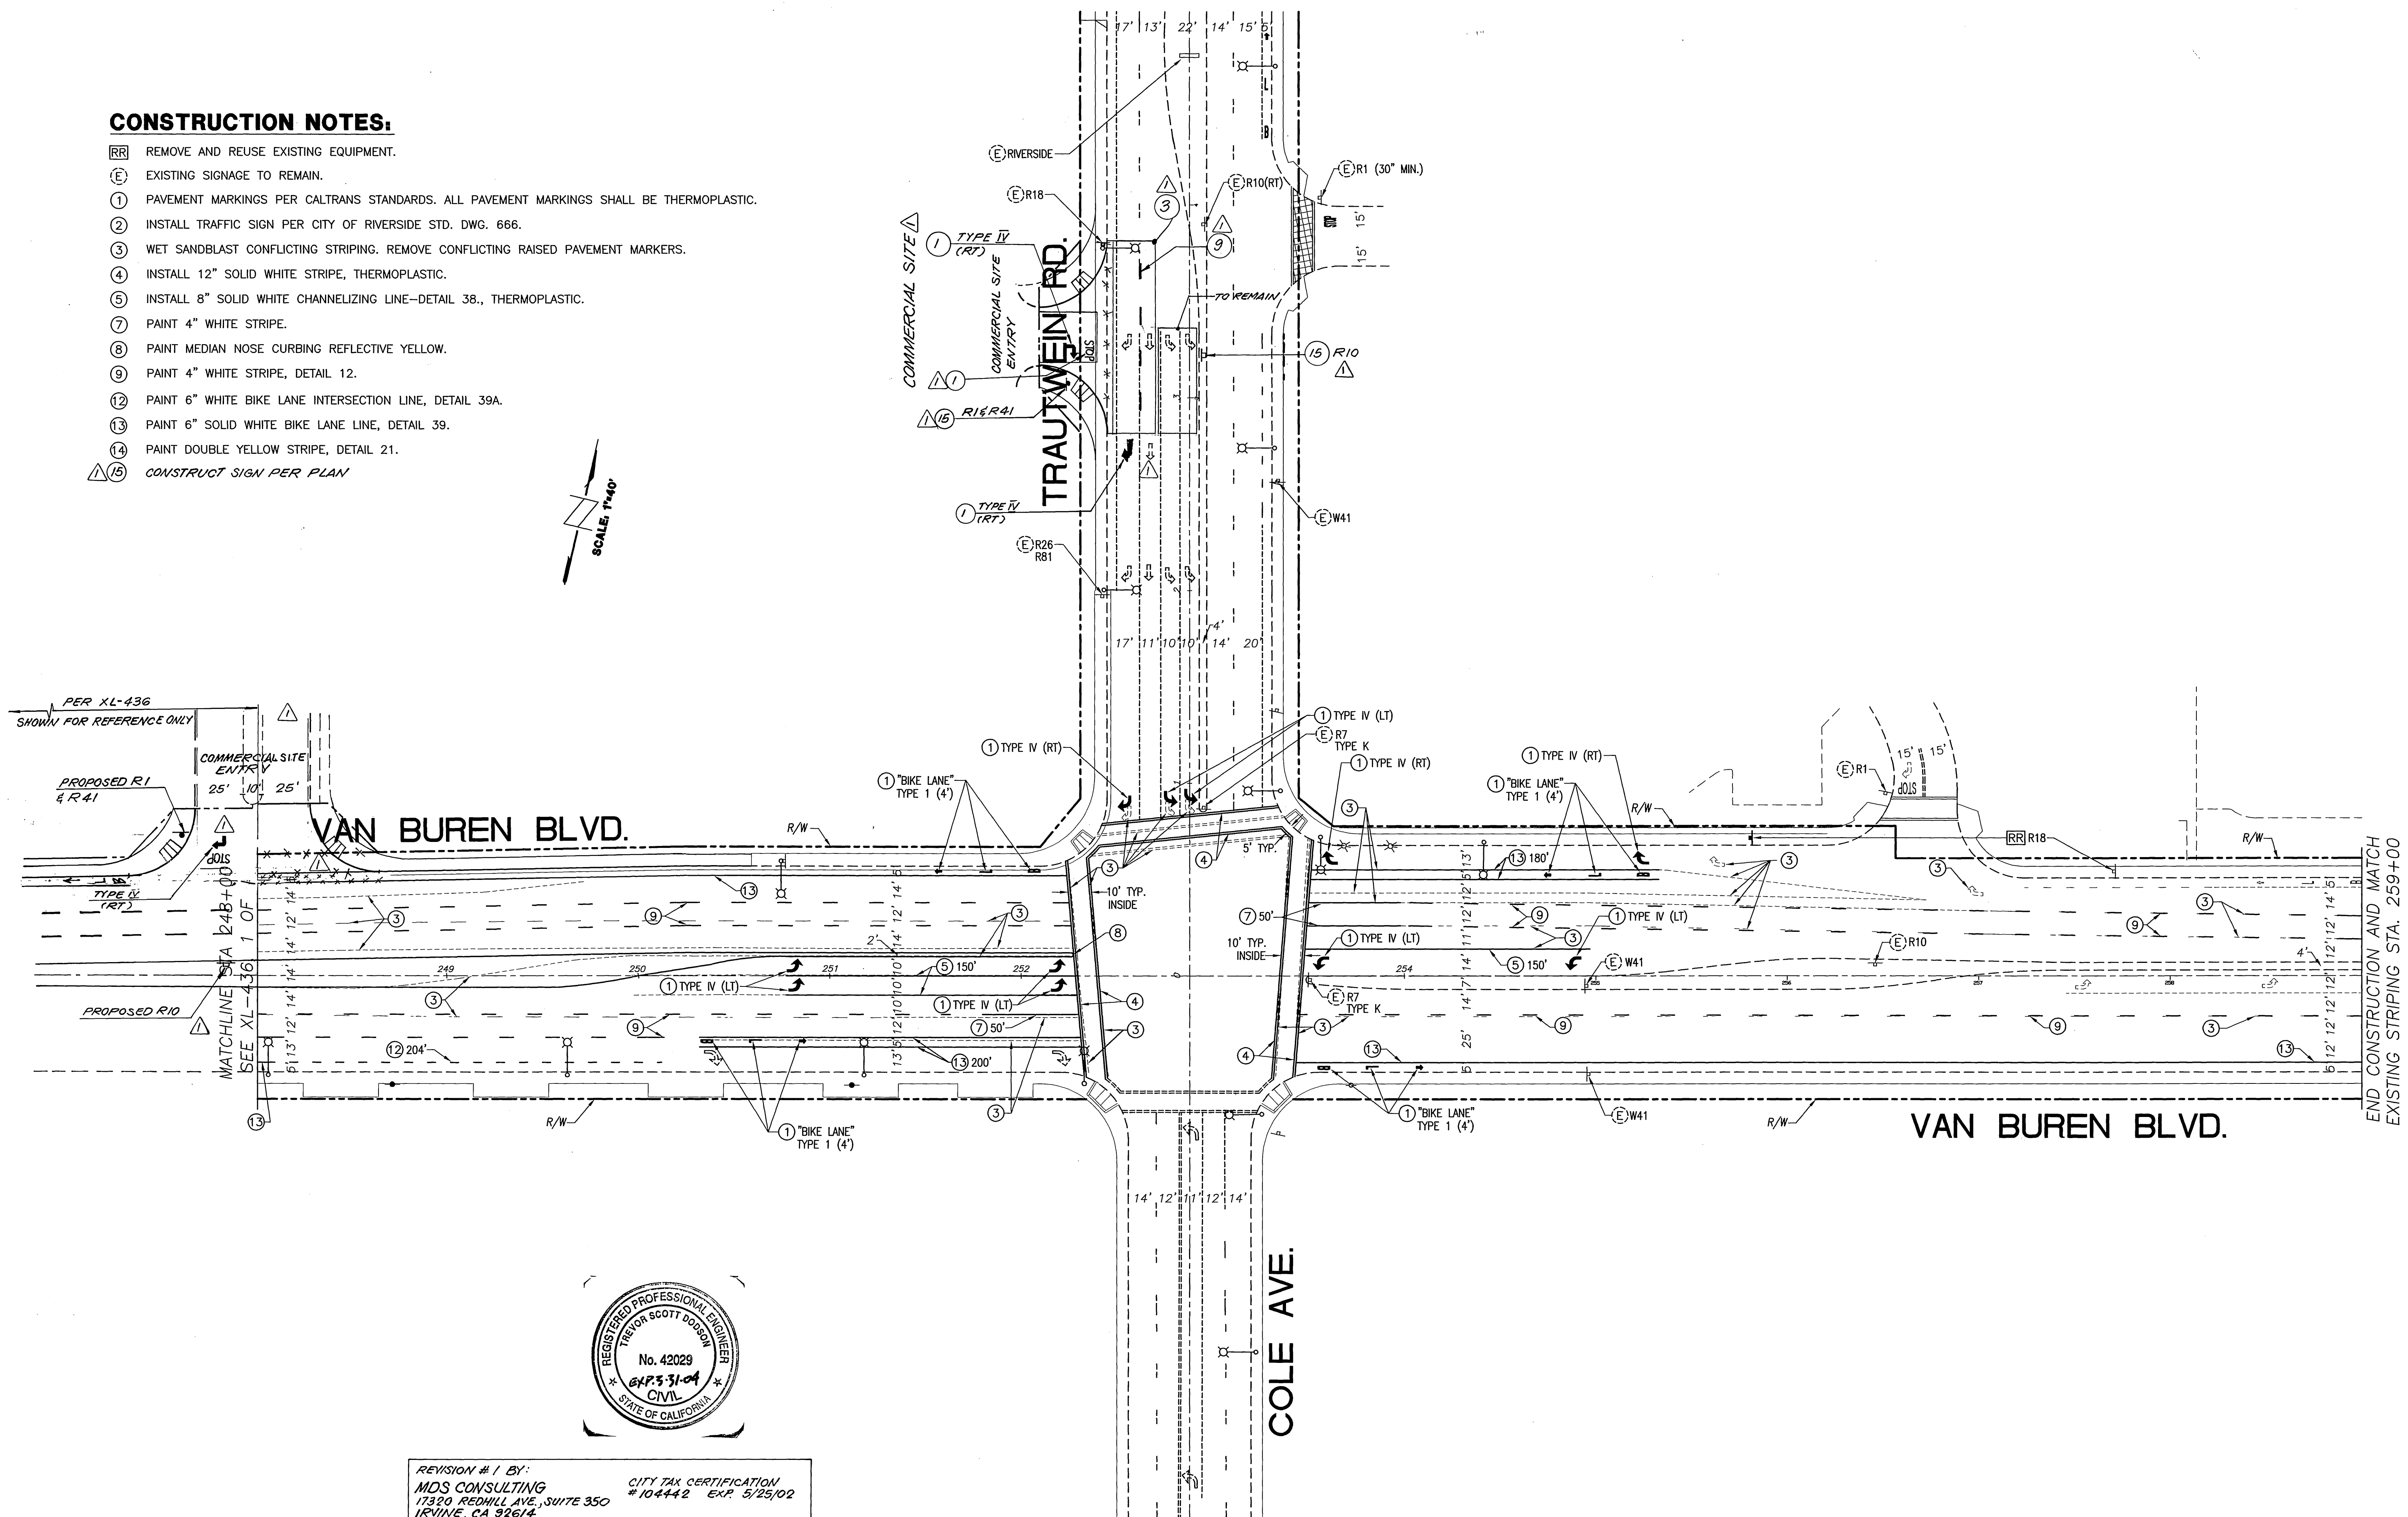

REVISION # 1 BY:  
 MDS CONSULTING CITY TAX CERTIFICATION  
 17320 REDHILL AVE., SUITE 350 # 104442 EXP. 5/25/02  
 IRVINE, CA 92614  
 (949) 251-8821  
 Trevor S. Dodson 4.3.02  
 TREVOR S. DODSON RCE # 42029 DATE

**PRIVATE ENGINEERING NOTE**

CONSTRUCTION CONTRACTOR AGREES THAT IN ACCORDANCE WITH GENERALLY ACCEPTED CONSTRUCTION PRACTICES, CONSTRUCTION CONTRACTOR WILL BE REQUIRED TO ASSUME SOLE AND COMPLETE RESPONSIBILITY FOR JOB SITE CONDITIONS DURING THE COURSE OF CONSTRUCTION OF THE PROJECT, INCLUDING SAFETY OF ALL PERSONS AND PROPERTY. THAT THIS REQUIREMENT SHALL BE MADE TO APPLY CONTINUOUSLY AND NOT BE LIMITED TO NORMAL WORKING HOURS, AND HOLD DESIGN PROFESSIONAL HARMLESS FROM ANY AND ALL LIABILITY, REAL OR ALLEGED, IN CONNECTION WITH THE PERFORMANCE OF WORK ON THIS PROJECT, EXCEPTING LIABILITY ARISING FROM THE SOLE NEGLIGENCE OF DESIGN PROFESSIONAL.



PREPARED UNDER THE DIRECTION OF:  
 Robert Kahn  
 REGISTERED CIVIL ENGINEER NO. 20285  
 EXPIRATION DATE: 09-30-01 DATE: 4/10/00



1601 Dove St., Suite 290 • Newport Beach, CA 92660  
 Phone: (949) 474-0809 Fax: (949) 474-0902

SCALE: 1" = 40'  
 DATE: 1/25/00

CITY OF RIVERSIDE, CALIFORNIA  
 DEPARTMENT OF PUBLIC WORKS

APPROVED BY	BY	DATE
PRINCIPAL ENGR.	<i>[Signature]</i>	4/15/00
PARK DEPARTMENT		
TRAFFIC DIVISION		
P.W. ENGINEER MGR.		
STREET SERVICES		

APPROVED BY  
*R. M. Grath*  
 DIRECTOR OF PUBLIC WORKS  
 DATE 5-3-2000

TRACT No. 28866  
 SIGNING AND STRIPING PLAN  
 VAN BUREN BLVD.  
 AND  
 TRAUTWEIN RD.

PROJECT NO.  
 XL-439  
 SHEET 1 OF 1  
 FOR: COMMUNITIES SOUTHWEST  
 FILE NO.