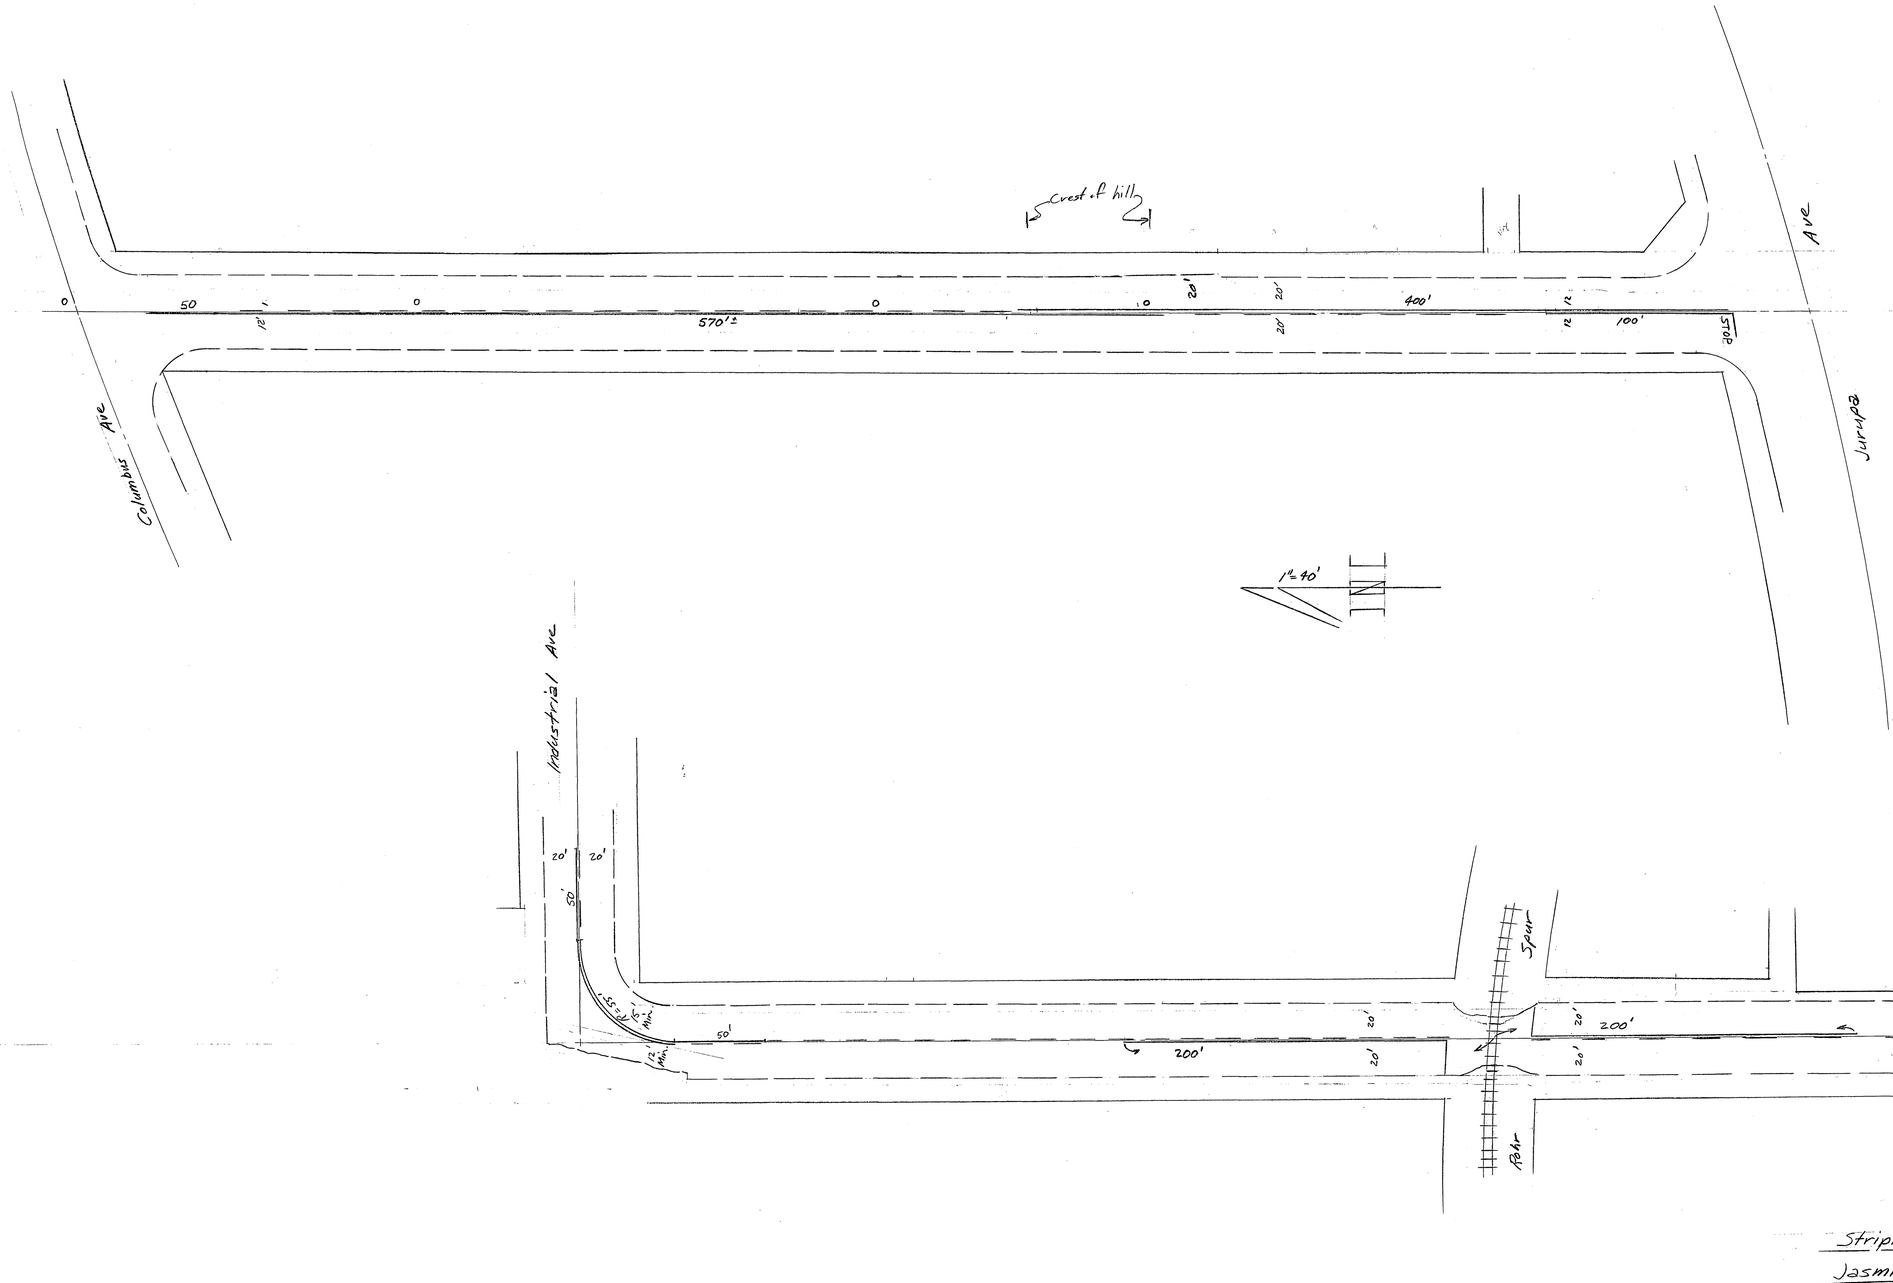

Striping Plan
Jasmine St
7/6/77 O. Ray

REVISED PER PLAN 2264
STREET IMPROVEMENTS
5/26/82 G. JUAREZ

XL-73