


Central Ave

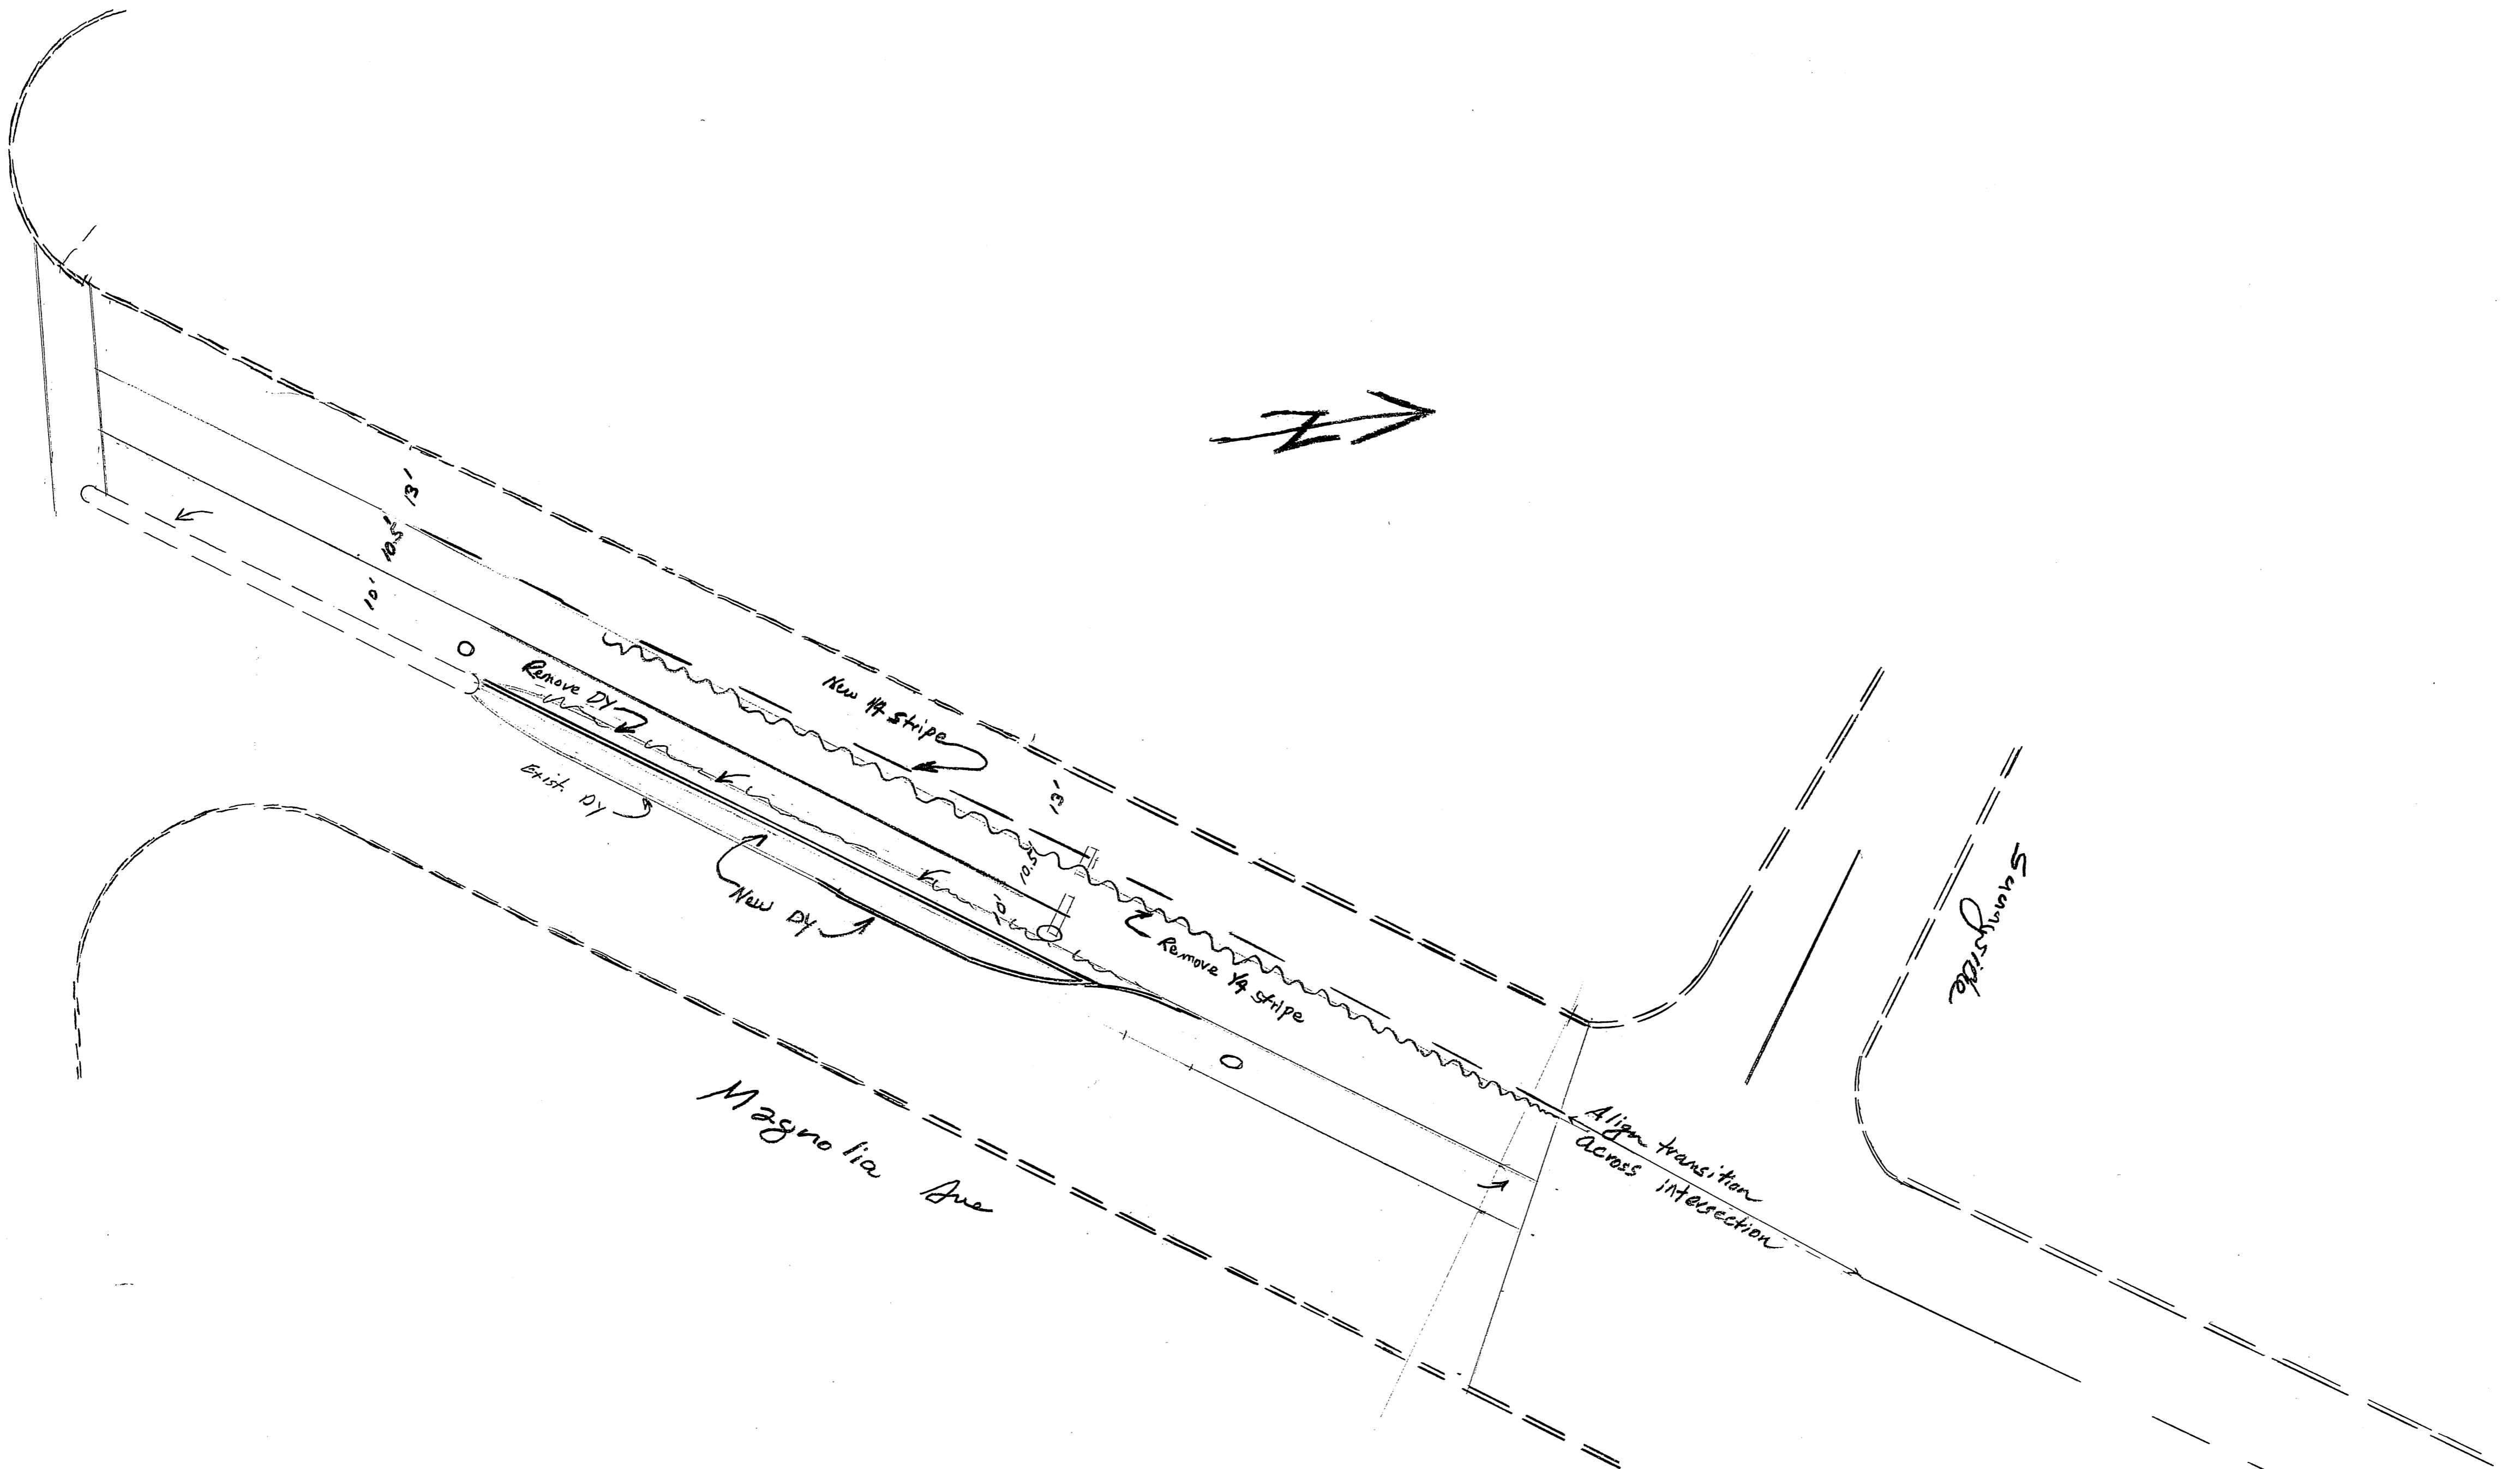

Magnolia Ave N/O Central
Extend left turn lane
XL-78