


SAN DIEGO


RIVERSIDE AVE.

ARLINGTON AVE.

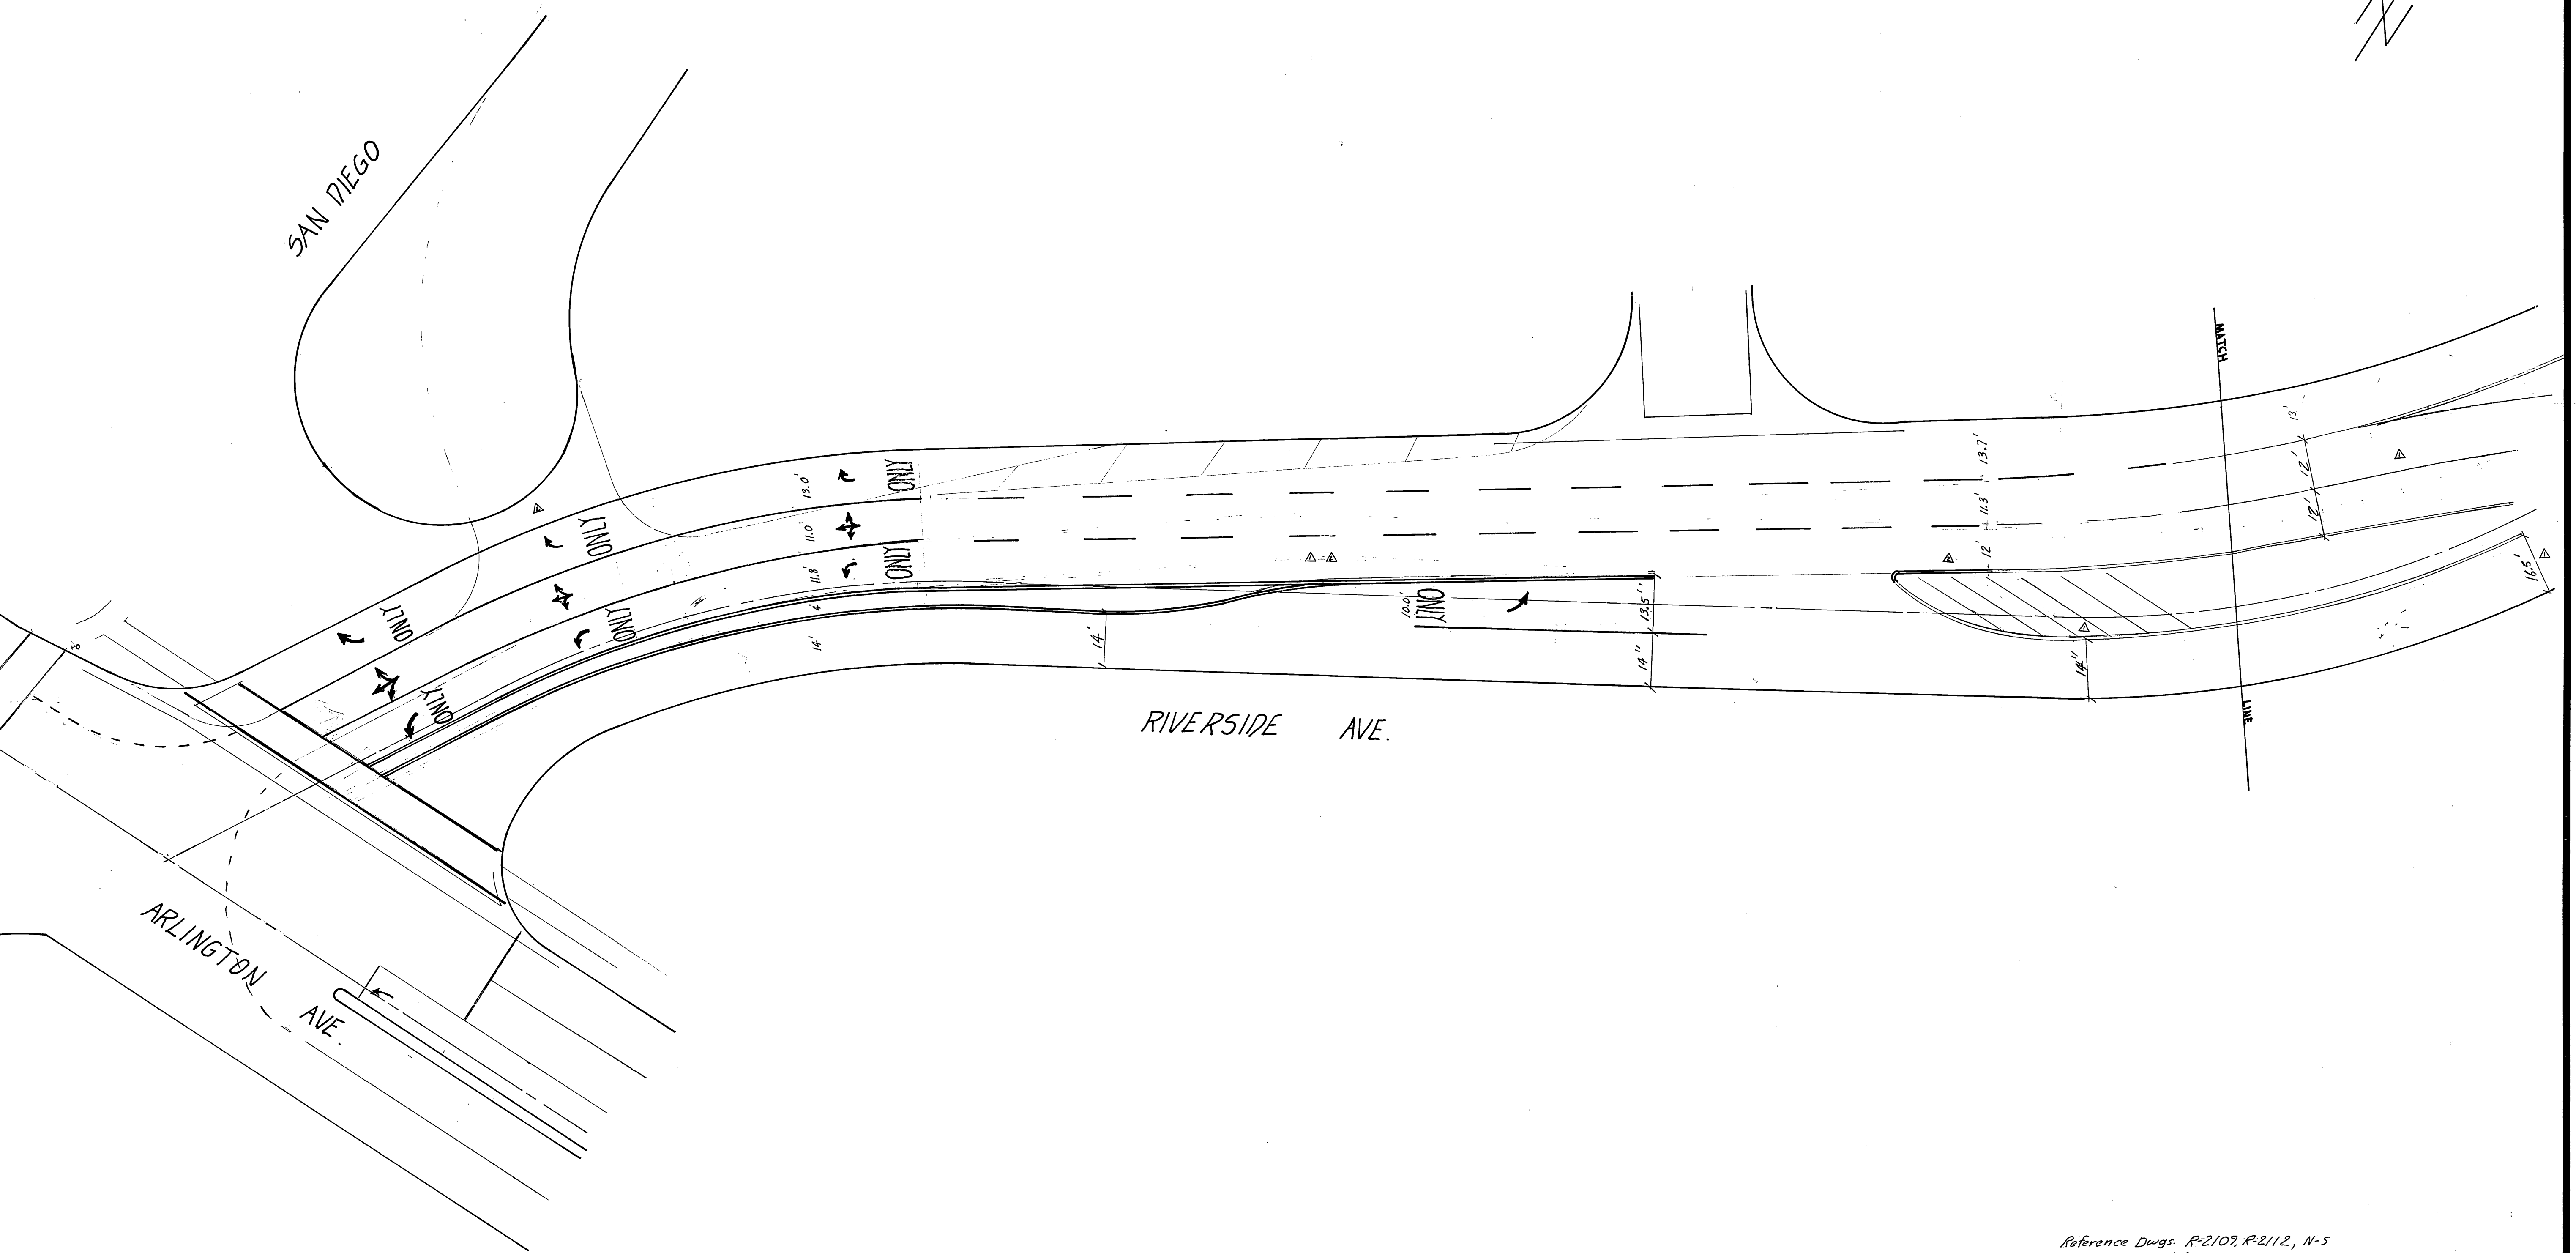

Reference Dwg. R-2107, R-2112, N-5  
 Fwy plans & auxiliary fwy lanes (pm) plans (1980).

				<b>CITY OF RIVERSIDE</b>		<b>PUBLIC WORKS DEPARTMENT</b>		<b>RIVERSIDE AVE</b>		ACCOUNT NO.	
				APPROVED BY		BY		DATE		APPROVED BY	
				PRINCIPAL ENGINEER		PARK DEPARTMENT		TRAFFIC DIVISION		CHIEF P. W. ENGINEER	
				REVISIONS		APPR. DATE		DATE		DATE	
				DESIGNED BY <i>D. Ray</i>		DRAWN BY <i>R.G.</i>		CHECKED BY		DATE	
				Add 3rd lane & Cal-De-Sac San Diego		<i>D. Ray</i>		<i>3/81</i>		DATE	
				Caltrans revid ramp & Striping		<i>(Not Reviewed)</i>		<i>1/80</i>		DATE	
				APPROVED BY		BY		DATE		APPROVED BY	
				DATE		DATE		DATE		DATE	
				HORIZ. SCALE: 1" = 20'		VERT. SCALE: 1" =		SHEET		OF	
				XL-96		SHEET		OF		2	

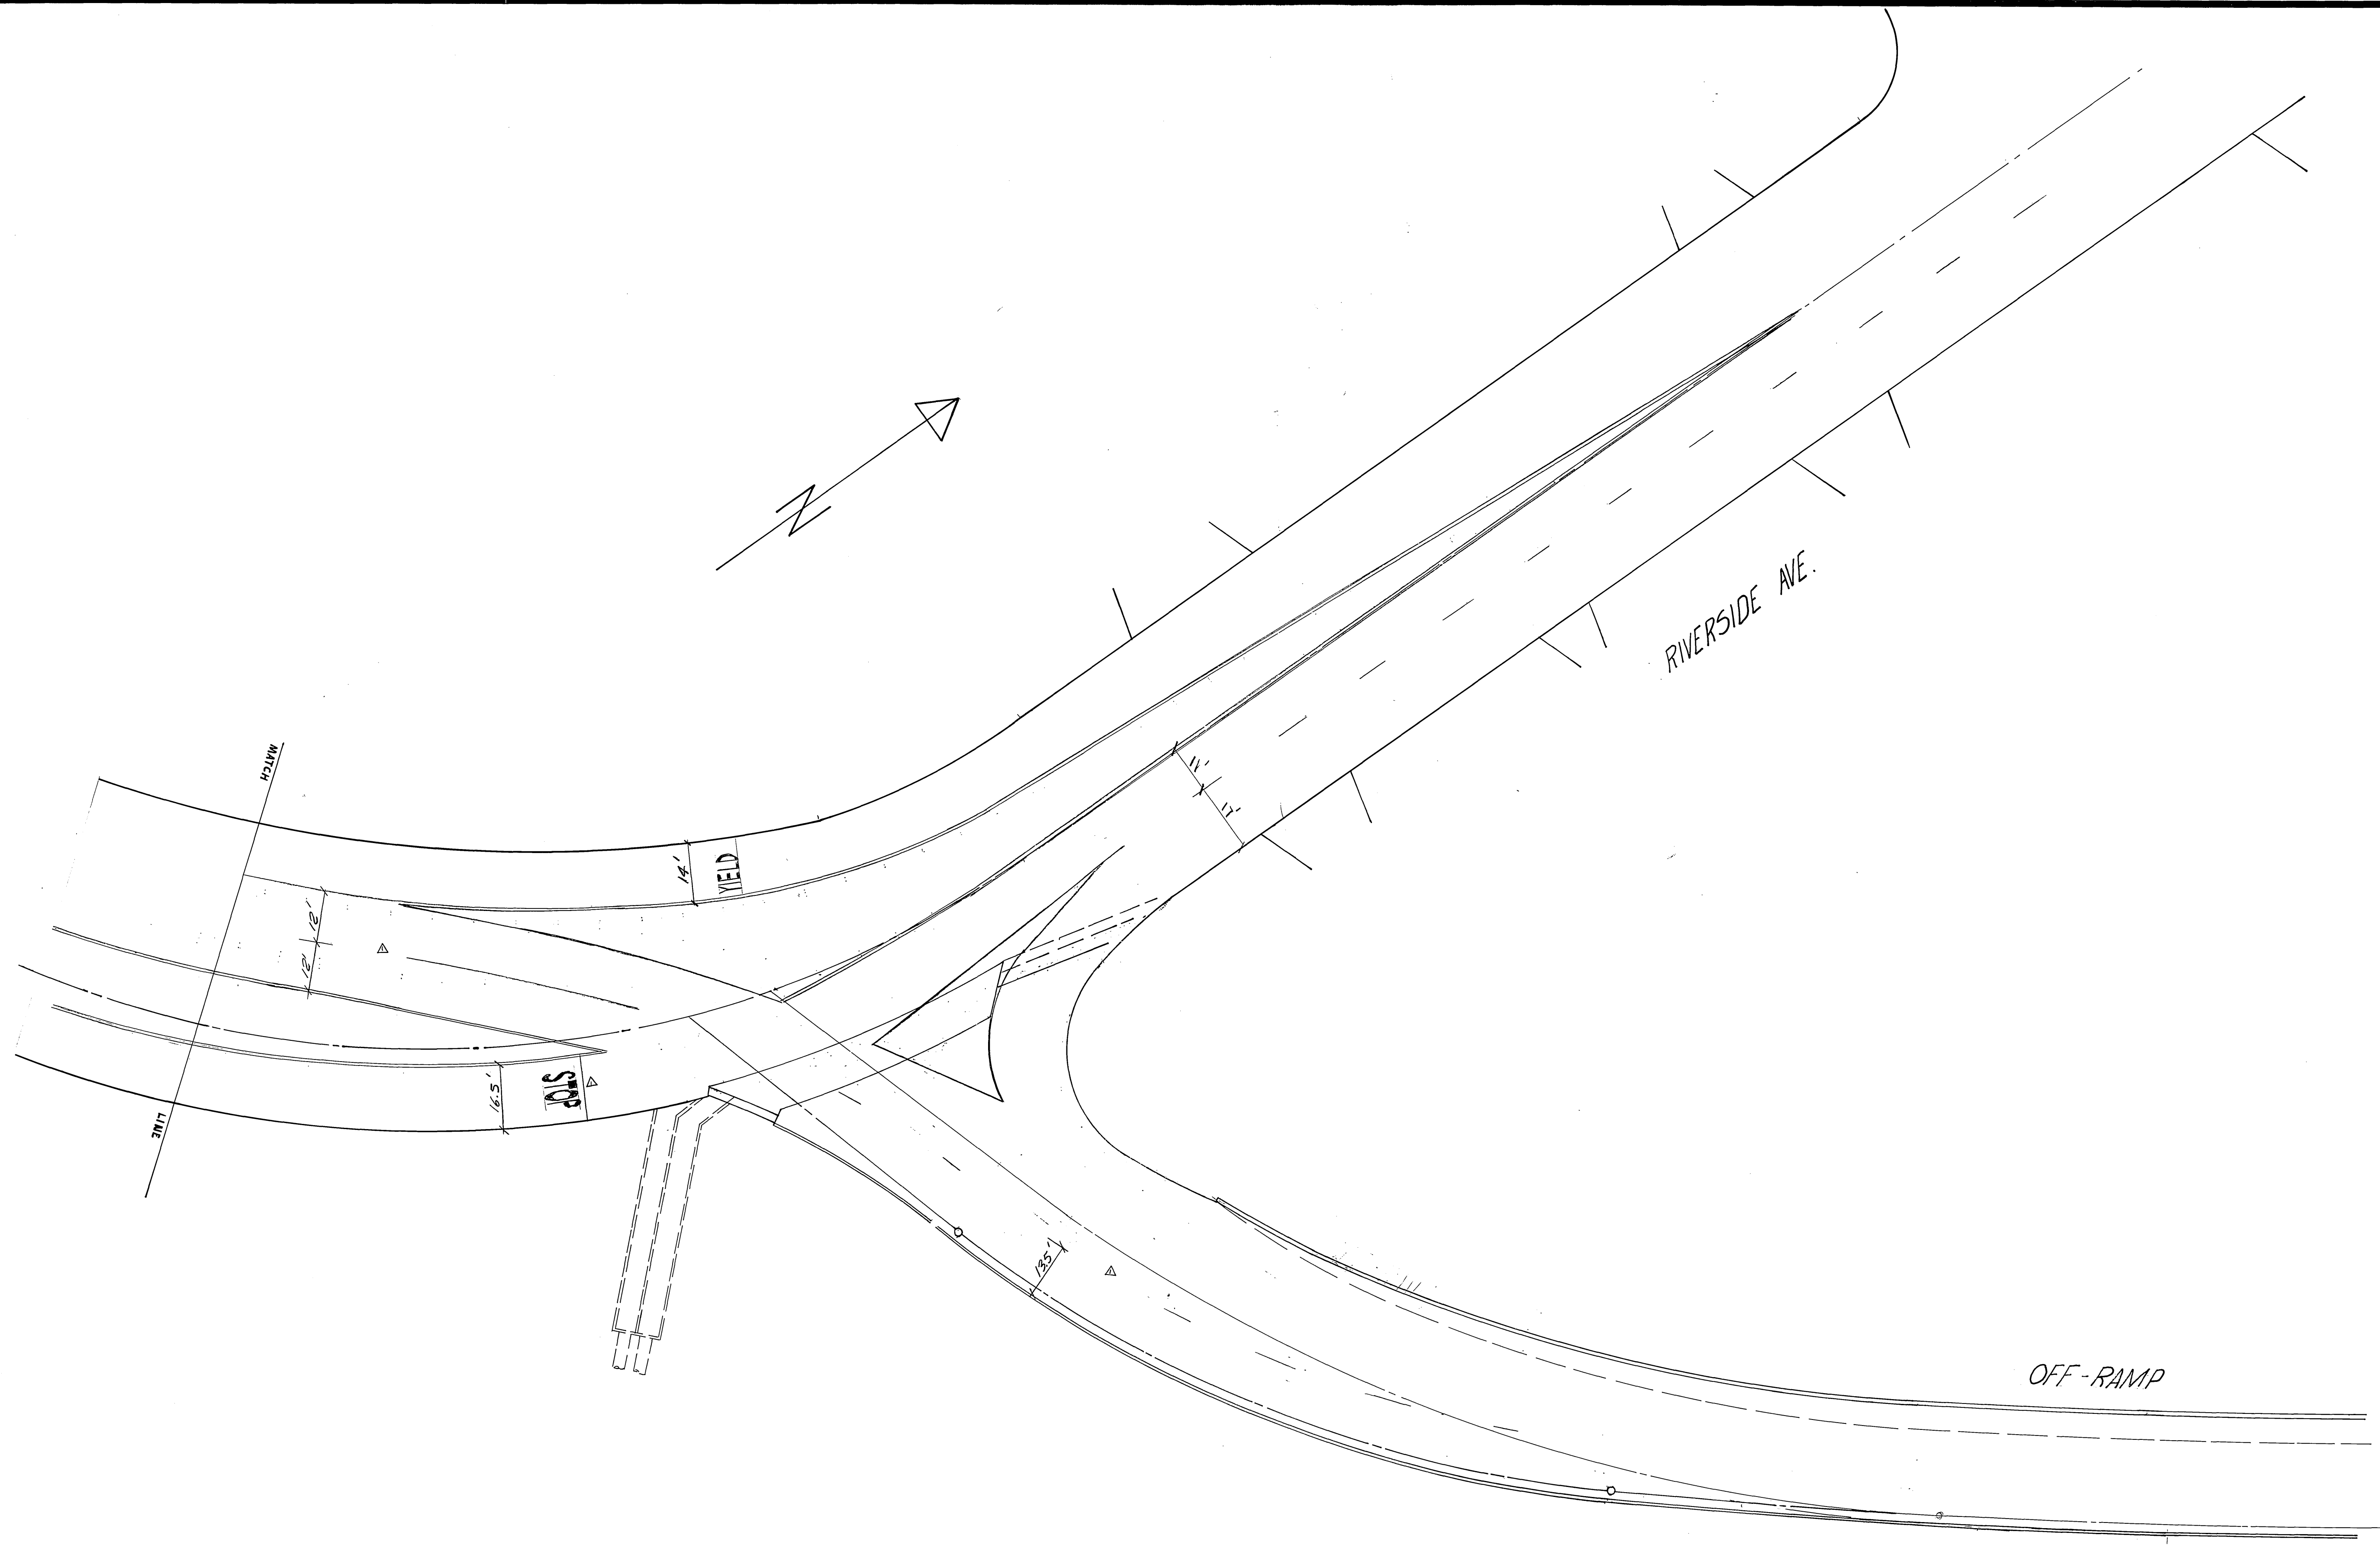

Reference Dwg: R-2112 of Caltrans auxiliary lane project plans.

<b>CITY OF RIVERSIDE</b> <b>PUBLIC WORKS DEPARTMENT</b>			<b>RIVERSIDE AVE</b> Arlington to Fwy. Off-Ramp Striping & Street Revisions		ACCOUNT NO. <b>XL-96</b>
APPROVED BY PRINCIPAL ENGINEER	BY PARK DEPARTMENT	DATE 1980	APPROVED BY TRAFFIC DIVISION	DATE	SHEET <b>2</b> OF <b>2</b>
DESIGNED BY <i>D.Ry.</i> DRAWN BY <i>R.G.</i> CHECKED BY			HORIZ. SCALE: 1" = 20' VERT. SCALE: 1" =		